


**DENISON
LANDSCAPING**

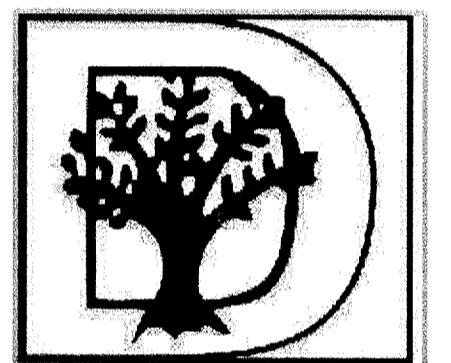

PROJECT TITLE

**SYMPHONY
VILLAGE**

CENTERVILLE
QUEEN ANNES COUNTY
MARYLAND

SHEET TITLE

**IRRIGATION
LAYOUT
AS-BUILT
PLAN**

ISSUE BLOCK

MARK DATE DESCRIPTION

PROJECT NO.: 2009003

DATE: 02/06/2009


SCALE: 1" = 60'

DRAWN BY: CGD | PROJ. MGR.: VAW

SHEET

PHASE 4

COPYRIGHT 2007

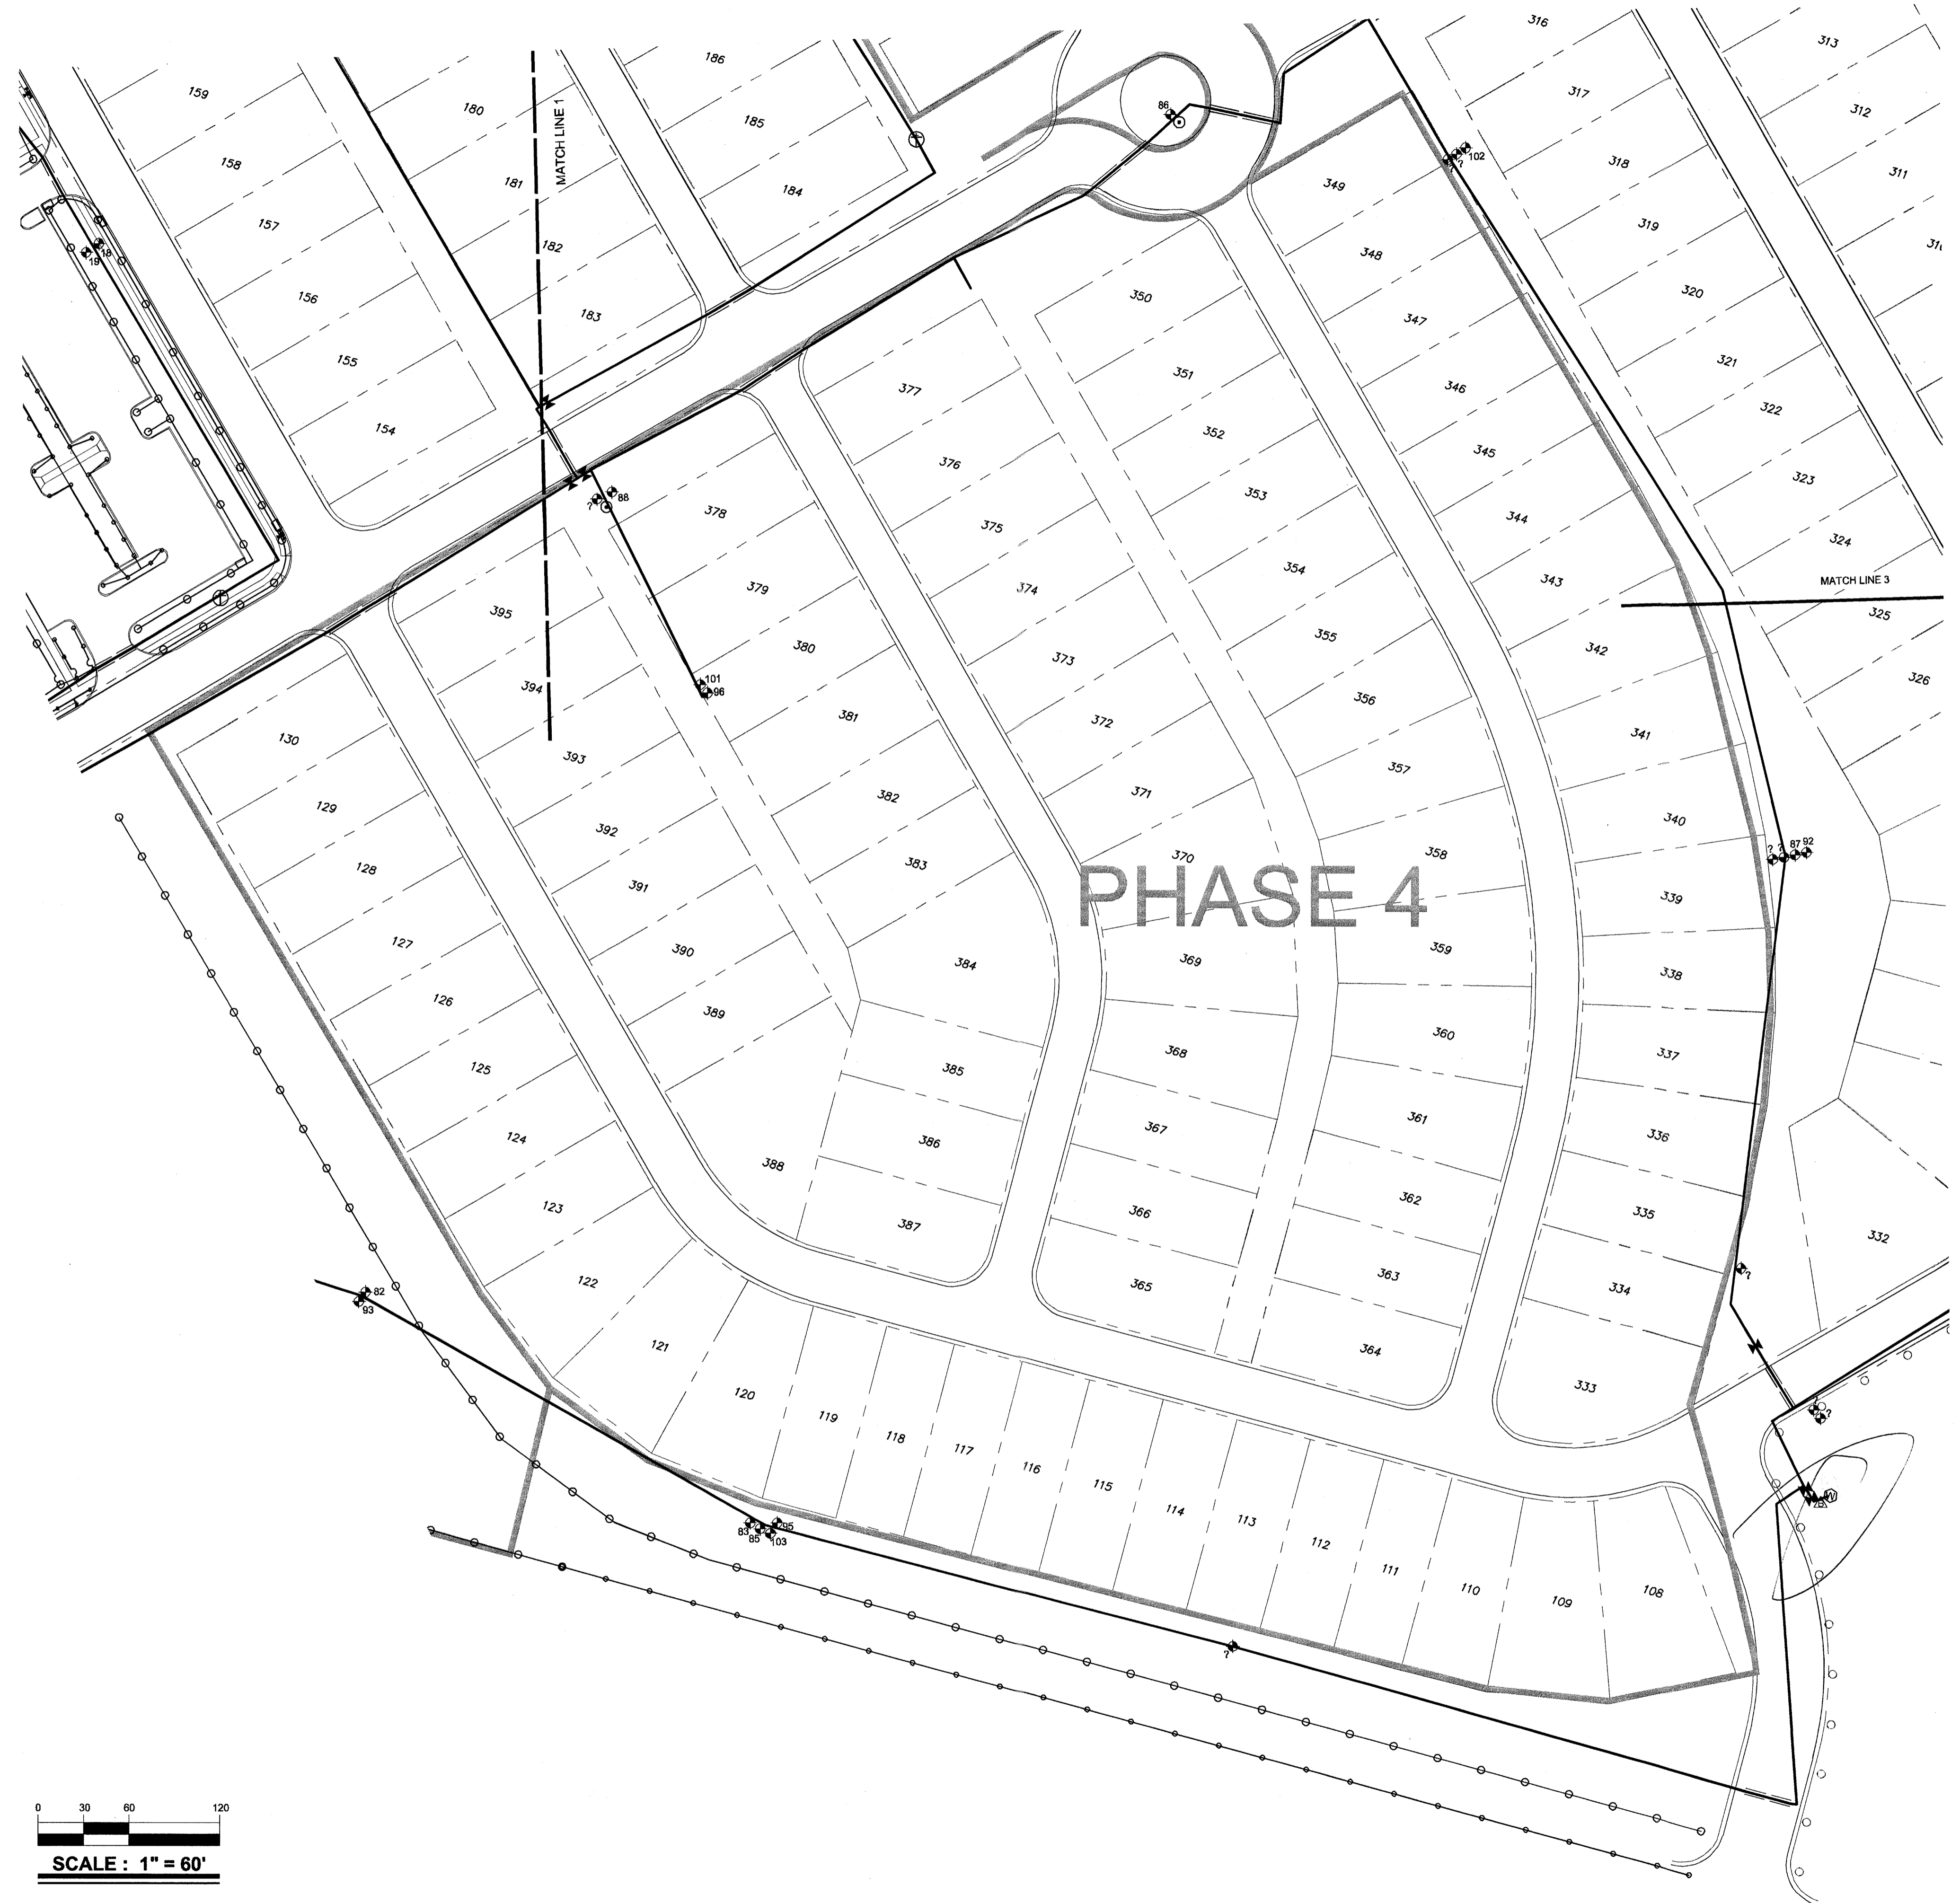

- IRRIGATION LEGEND**
- HUNTER, 120ADJU GEAR DRIVEN ROTOR, W/MPR NOZZLE
 - HUNTER, PRO SERIES, 08" POP UP SPRAY, W/MPR NOZZLE
 - HUNTER, PRO SERIES, 08" POP UP SPRAY, W/MICRO-SPRAY NOZZLES
 - ⊙ GCV100, QUICK COUPLING VALVE, 1"
 - ⊗ HUNTER, HBV-301E SERIES, ELECTRIC VALVE, 3" W NUMBER
 - ⊠ TUCOR, 2-WIRE, AUTOMATIC CONTROLLER
 - △ PRESSURE POP OFF VALVE
 - △ FLOW SENSOR
 - ⊕ WIRE SPLICE
 - △ HUNTER, MINICLICK, AUTOMATIC RAIN SENSOR
 - ⊠ ISOLATION GATE VALVE, MAINLINE SIZE
 - ⊙ WELL LOCATION
 - ⊗ WILKINS, 975XLV250, REDUCED PRESSURE BACKFLOW PREVENTER, 2.5"
 - PVC MAINLINE, CLASS 200, BE, SIZE 4"
 - △ OTHER/MISC IRRIGATION BOX
 - SLEEVE

