


**DENISON
LANDSCAPING**

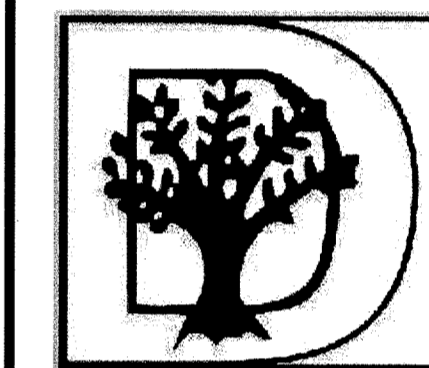

PROJECT TITLE

**SYMPHONY
VILLAGE**

CENTERVILLE
QUEEN ANNES COUNTY
MARYLAND

SHEET TITLE

**IRRIGATION
LAYOUT
AS-BUILT
PLAN**

ISSUE BLOCK

MARK DATE DESCRIPTION

PROJECT NO.: 2009003


DATE: 02/06/2009

SCALE: 1" = 60'

DRAWN BY: CGD PROJ. MGR.: VAW

PHASE 2

COPYRIGHT 2007

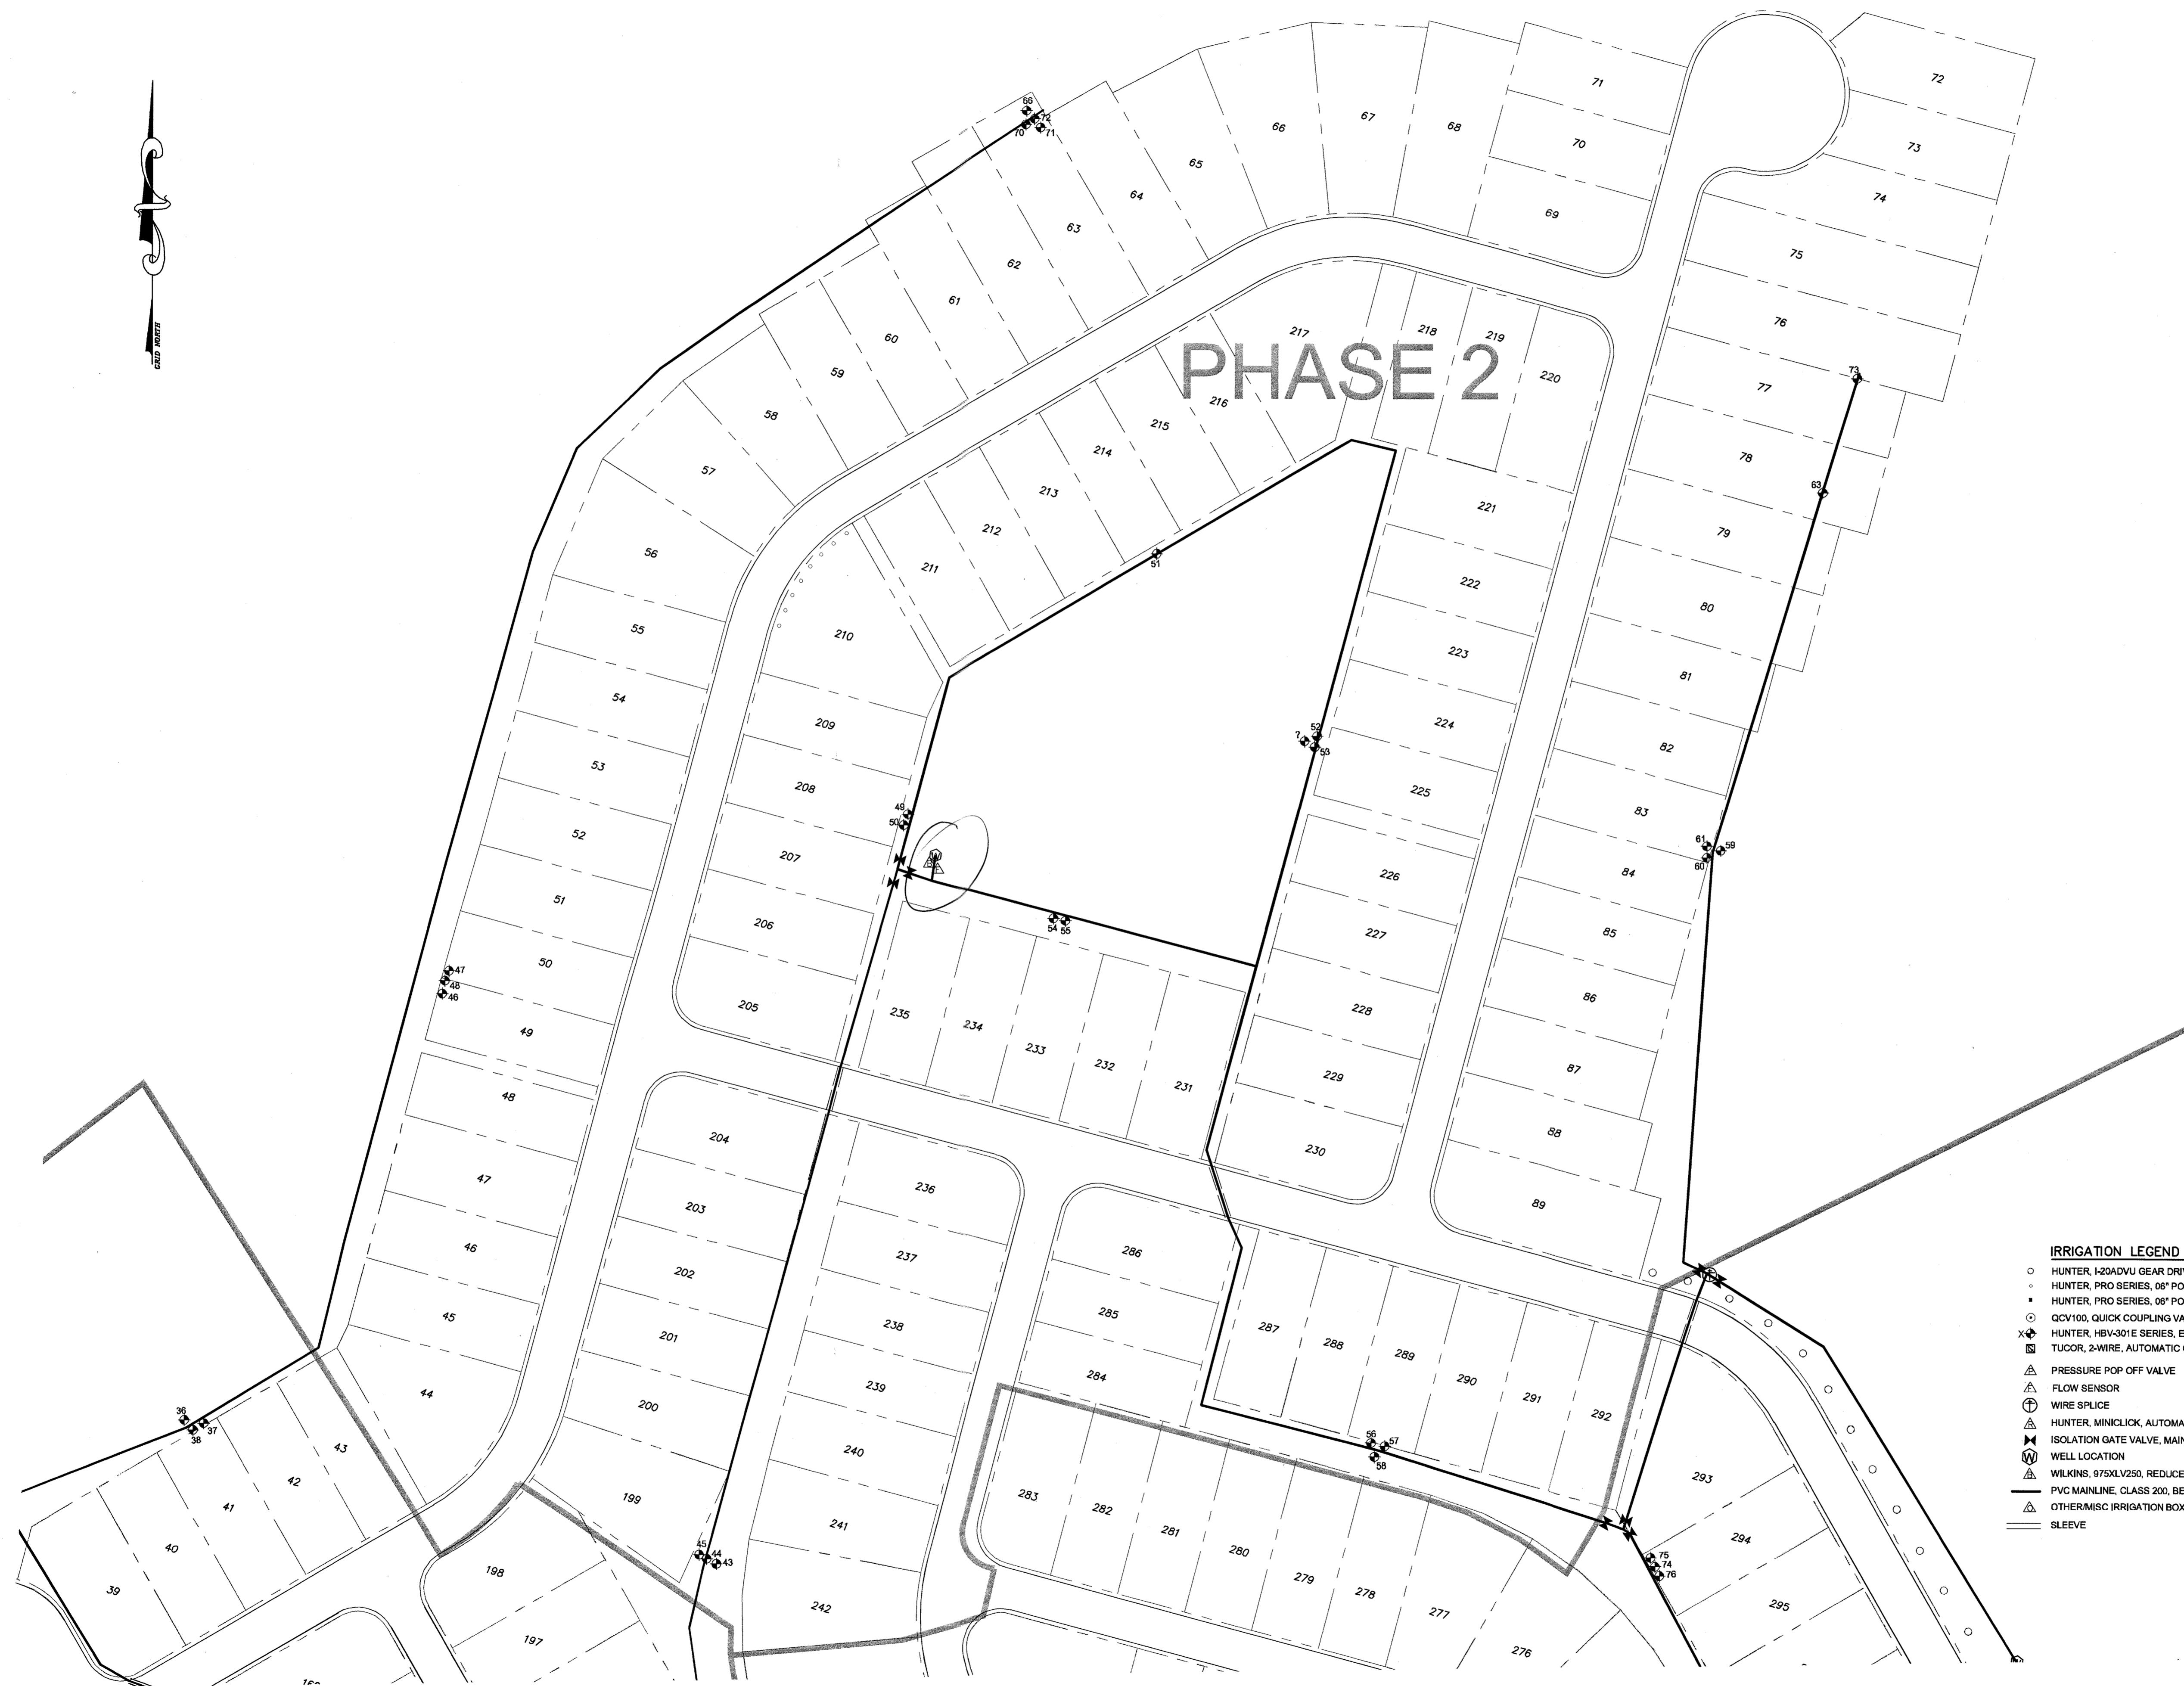

- IRRIGATION LEGEND**
- HUNTER, I-20ADVU GEAR DRIVEN ROTOR, W/ MPR NOZZLE
 - HUNTER, PRO SERIES, 06" POP UP SPRAY, W/ MPR NOZZLE
 - HUNTER, PRO SERIES, 06" POP UP SPRAY, W/ MICRO-SPRAY NOZZLES
 - QCV100, QUICK COUPLING VALVE, 1"
 - ⊗ HUNTER, HBV-301E SERIES, ELECTRIC VALVE, 3" w/ NUMBER
 - ⊗ TUCOR, 2-WIRE, AUTOMATIC CONTROLLER
 - △ PRESSURE POP OFF VALVE
 - △ FLOW SENSOR
 - ⊕ WIRE SPLICE
 - △ HUNTER, MINICLICK, AUTOMATIC RAIN SENSOR
 - ⊕ ISOLATION GATE VALVE, MAINLINE SIZE
 - ⊕ WELL LOCATION
 - △ WILKINS, 975XLV250, REDUCED PRESSURE BACKFLOW PREVENTER, 2.5"
 - PVC MAINLINE, CLASS 200, BE, SIZE 4"
 - △ OTHER MISC IRRIGATION BOX
 - SLEEVE

