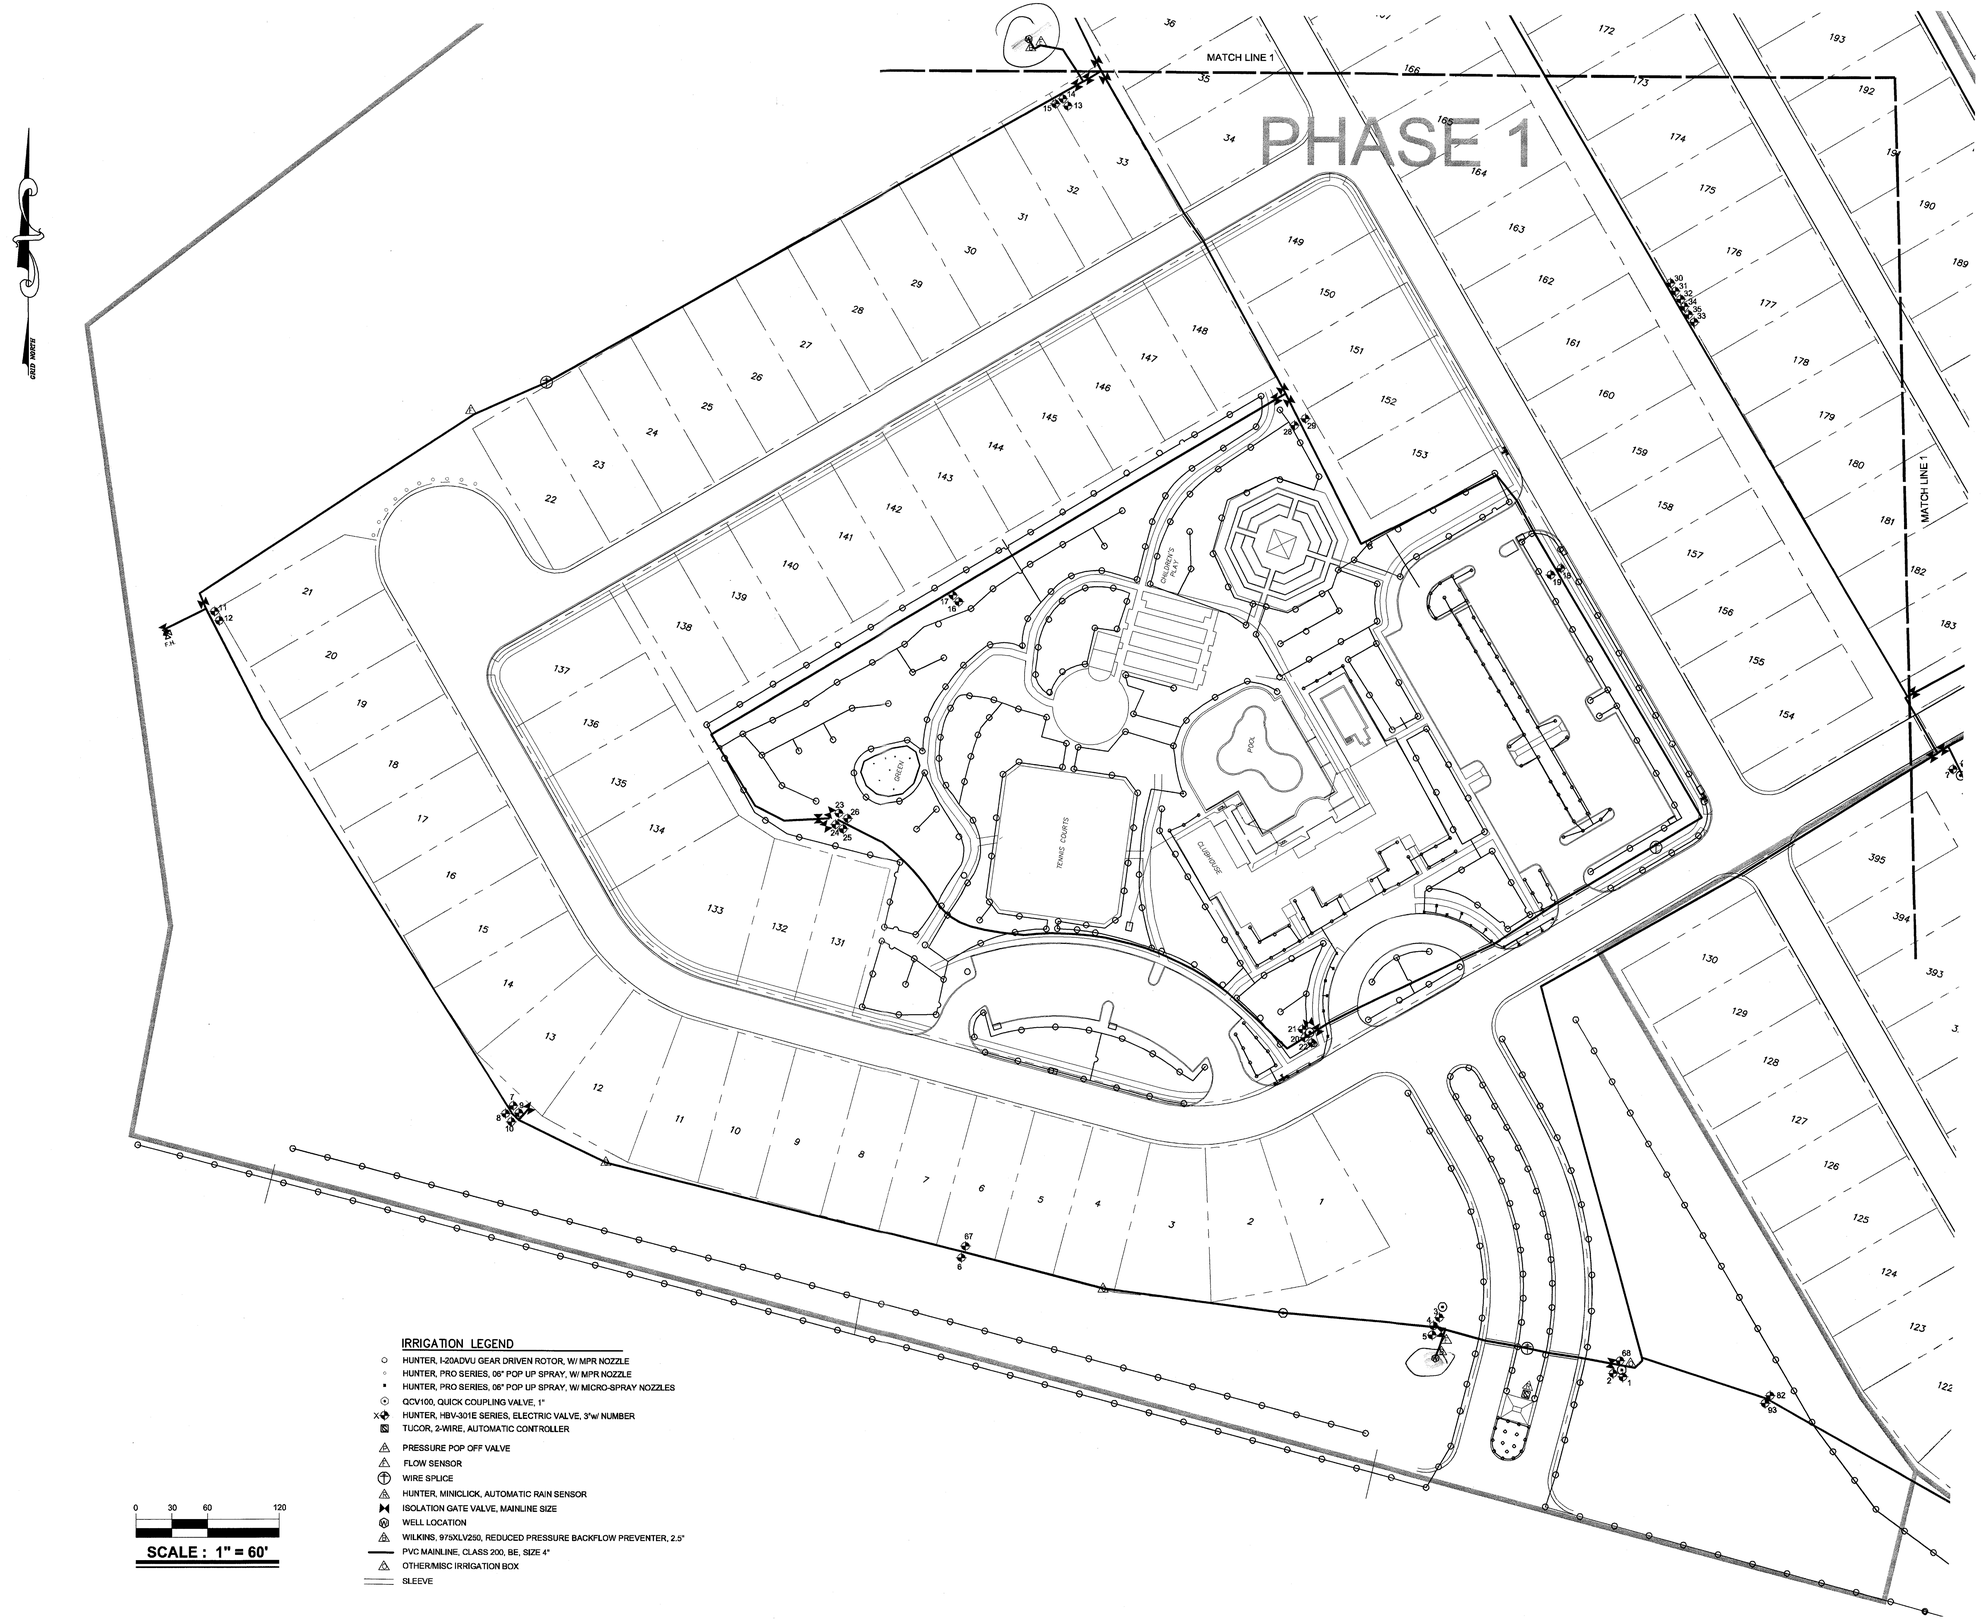

BECKER MORGAN GROUP

ARCHITECTURE
ENGINEERING

Dover
309 S. Governors Ave.
Dover, DE 19904
Ph. 302.734.7950
Fax 302.734.7965

Salisbury
312 West Main St. Suite 300
Salisbury, MD 21801
Ph. 410.546.9100
Fax 410.546.5824

Wilmington
307 A Street
Wilmington, DE 19801
Ph. 302.888.2600
Fax 302.888.2427

www.beckermorgan.com

DENISON LANDSCAPING

PROJECT TITLE

SYMPHONY VILLAGE

CENTERVILLE
QUEEN ANNES COUNTY
MARYLAND

SHEET TITLE

IRRIGATION LAYOUT AS-BUILT PLAN

ISSUE BLOCK

MARK	DATE	DESCRIPTION
LAYER:STATE - PHASE 1		

PROJECT NO.:	2009003
DATE:	02/06/2009
SCALE:	1" = 60'
DRAWN BY: CGD	PROJ. MGR.: VAW

SHEET

PHASE 1 SH. 1

COPYRIGHT 2007

Z:\LDT_Shared\2008_LDT\Prototypes\BMG\DWG\SURVEY.dwg 9/3/2008 7:54:11 AM EDT