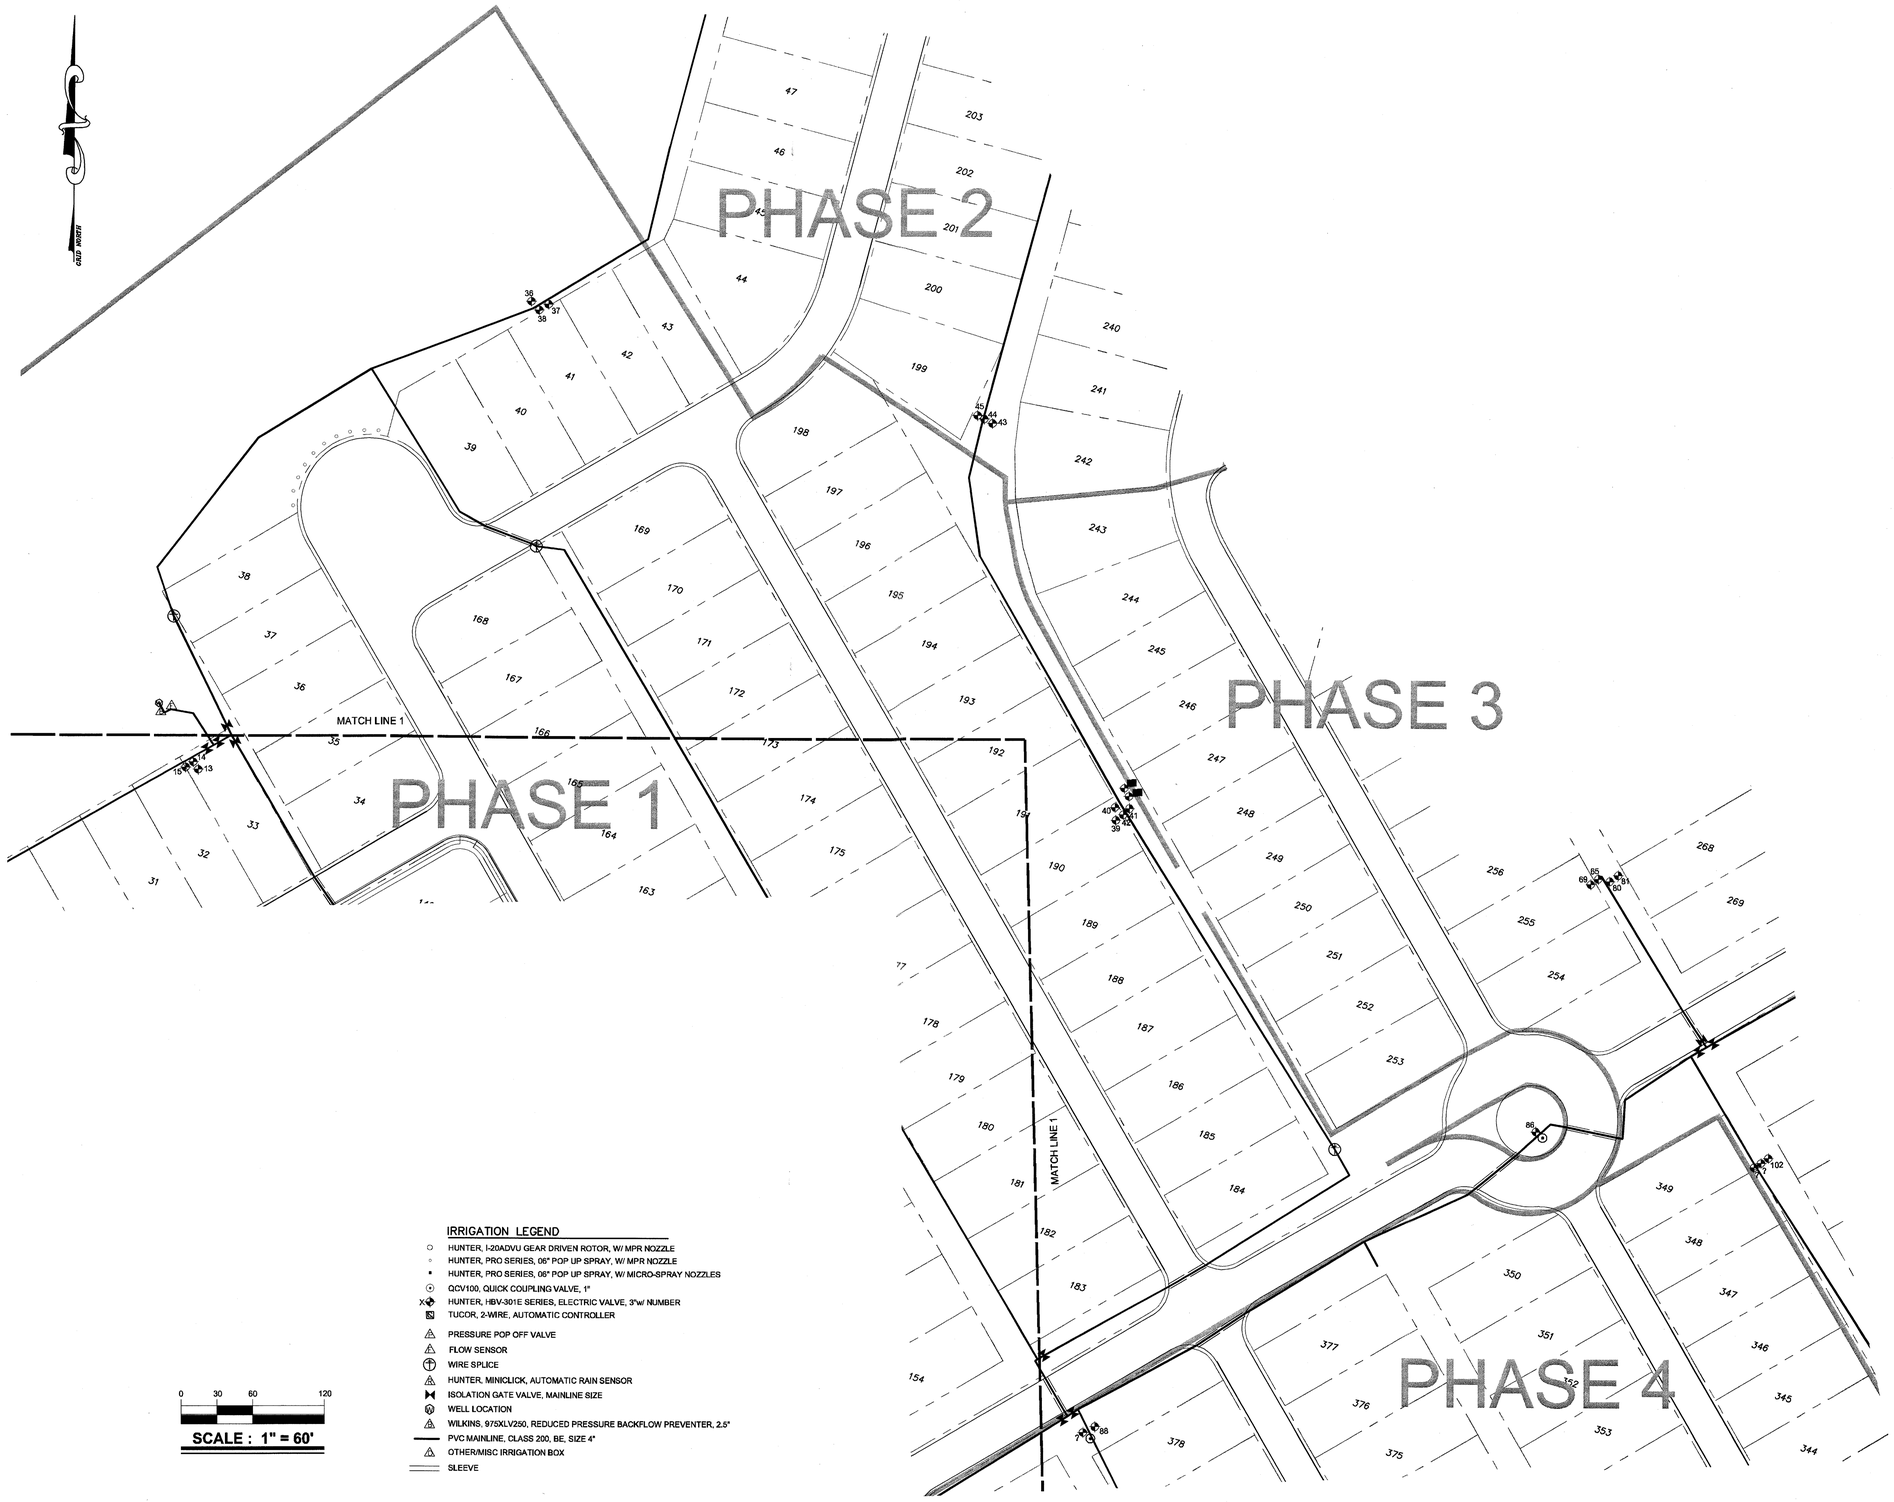

IRRIGATION LEGEND

- HUNTER, I-20ADVU GEAR DRIVEN ROTOR, W/ MPR NOZZLE
- HUNTER, PRO SERIES, 06" POP UP SPRAY, W/ MPR NOZZLE
- HUNTER, PRO SERIES, 06" POP UP SPRAY, W/ MICRO-SPRAY NOZZLES
- QCV100, QUICK COUPLING VALVE, 1"
- X HUNTER, HBV-301E SERIES, ELECTRIC VALVE, 3"w/ NUMBER
- TUCOR, 2-WIRE, AUTOMATIC CONTROLLER
- PRESSURE POP OFF VALVE
- FLOW SENSOR
- WIRE SPLICE
- HUNTER, MINICLICK, AUTOMATIC RAIN SENSOR
- ISOLATION GATE VALVE, MAINLINE SIZE
- WELL LOCATION
- WILKINS, 975XLV250, REDUCED PRESSURE BACKFLOW PREVENTER, 2.5"
- PVC MAINLINE, CLASS 200, BE, SIZE 4"
- OTHER/MISC IRRIGATION BOX
- SLEEVE

0 30 60 120

SCALE : 1" = 60'

BECKER MORGAN GROUP

ARCHITECTURE
ENGINEERING

Dover
309 S. Governors Ave.
Dover, DE 19904
Ph. 302.734.7950
Fax 302.734.7965

Salisbury
312 West Main St. Suite 300
Salisbury, MD 21801
Ph. 410.546.9100
Fax 410.546.5824

Wilmington
307 A Street
Wilmington, DE 19801
Ph. 302.888.2600
Fax 302.888.2427

www.beckermorgan.com

DENISON LANDSCAPING

PROJECT TITLE

SYMPHONY VILLAGE

CENTERVILLE
QUEEN ANNES COUNTY
MARYLAND

SHEET TITLE

IRRIGATION LAYOUT AS-BUILT PLAN

ISSUE BLOCK

MARK	DATE	DESCRIPTION

LAYOUTSTATE: PHASE1 (2)

PROJECT NO.:	2009003
DATE:	02/06/2009
SCALE:	1" = 60'
DRAWN BY: CGD	PROJ. MGR.: VAW

SHEET

PHASE 1 SH. 2

COPYRIGHT 2007

Z:\LDT_Shared\2008_LDT\Prototypes\BMG\DWG\SURVEY.dwg 9/3/2008 7:54:11 AM EDT